

SITE PLAN

PAINESVILLE TOWNSHIP, LAKE COUNTY, OHIO

for: JOHN CAMPBELL

ADDRESS STREET CITY ZIP

LANDMEN SUBDIVISION
SUBDIVISION 7-50
PT. 2+3
ELEV. 100.00
STREET

LEGEND

SANITARY MANHOLE
STORM MANHOLE
INLET OR CATCH BASIN
HYDRANT
EXISTING CONTOURS
PROPOSED CONTOURS
EXIST. ELEV. 100.00
PROP. ELEV. 100.00

REMARKS

ALL BOUNDARY DATA SHOWN WAS OBTAINED FROM IDEOS, RECORDED
SUBDIVISION PLAT OR OTHER PUBLIC RECORDS
LOCATIONS AS SHOWN OF ADJACENT WELLS AND SEPTIC TANKS OBTAINED FROM
LAKE COUNTY HEALTH DEPARTMENT

DESIGN CERTIFICATION

THIS PLAT WAS PREPARED BY ME, AND IS CORRECT
TO THE BEST OF MY KNOWLEDGE AND BELIEF
NAME SURVEYOR REGISTRATION NO. 6343

CHECK LIST

NO. OF BEDROOMS
BATHING
TOILET
SINK
STOVE
REF.
CUPB.
DISHW.
WASHER
DRAINAGE
WATER MAIN SIZE, LOCATION
SAN. SEWER SIZE & GR. LOC.
E&M, IN, C&T, ELEV. INV. ELEV.
SAN. CONC. SIZE, LOC. DEPTH
STORM SEWER SIZE & GR. LOC.
STORM IN, C&T, ELEV. INV. ELEV.
STORM TYPE GRADE CURVES
DAY LINE LOC. SIZE PRESSURE
SEPTIC TANK LOCATION & DUPLICATION
WELL LOCATION
ISOLATION RADIUS FROM WELL

PLAN PREPARED BY:
BABCOCK • JONES & ASSOCIATES, INC.
PAINESVILLE, OHIO

NO.	DATE	BY	SCALE	DATE	PHONE NO.
1			1" = 20'	5/21/90	357-1811
2					
3					
4					
5					

"AS BUILT" CERTIFICATION



I, HEREBY CERTIFY THAT THE CIRCLED GRADES ARE EXISTING
FINISH GRADES CHECKED IN THE FIELD ON 19__
AND ARE CORRECT TO THE BEST OF MY KNOWLEDGE AND BELIEF.

REGISTERED SURVEYOR REG. NO. 6343

T.B.M. - & P.W.M.T. - STA. 0+00 E.C.E. = 781.00

"I, the undersigned hereby certify that this topography
indicated by 6", 1' or 2' contours, and elevations shown
hereon represent an actual field survey made by me on
the 19__ day of 19__ and that the
elevations were taken at appropriate intervals and that as
of that date they existed as indicated hereon."

PAINESVILLE TOWNSHIP
ZONING APPROVED
#6343
Zoning Inspector

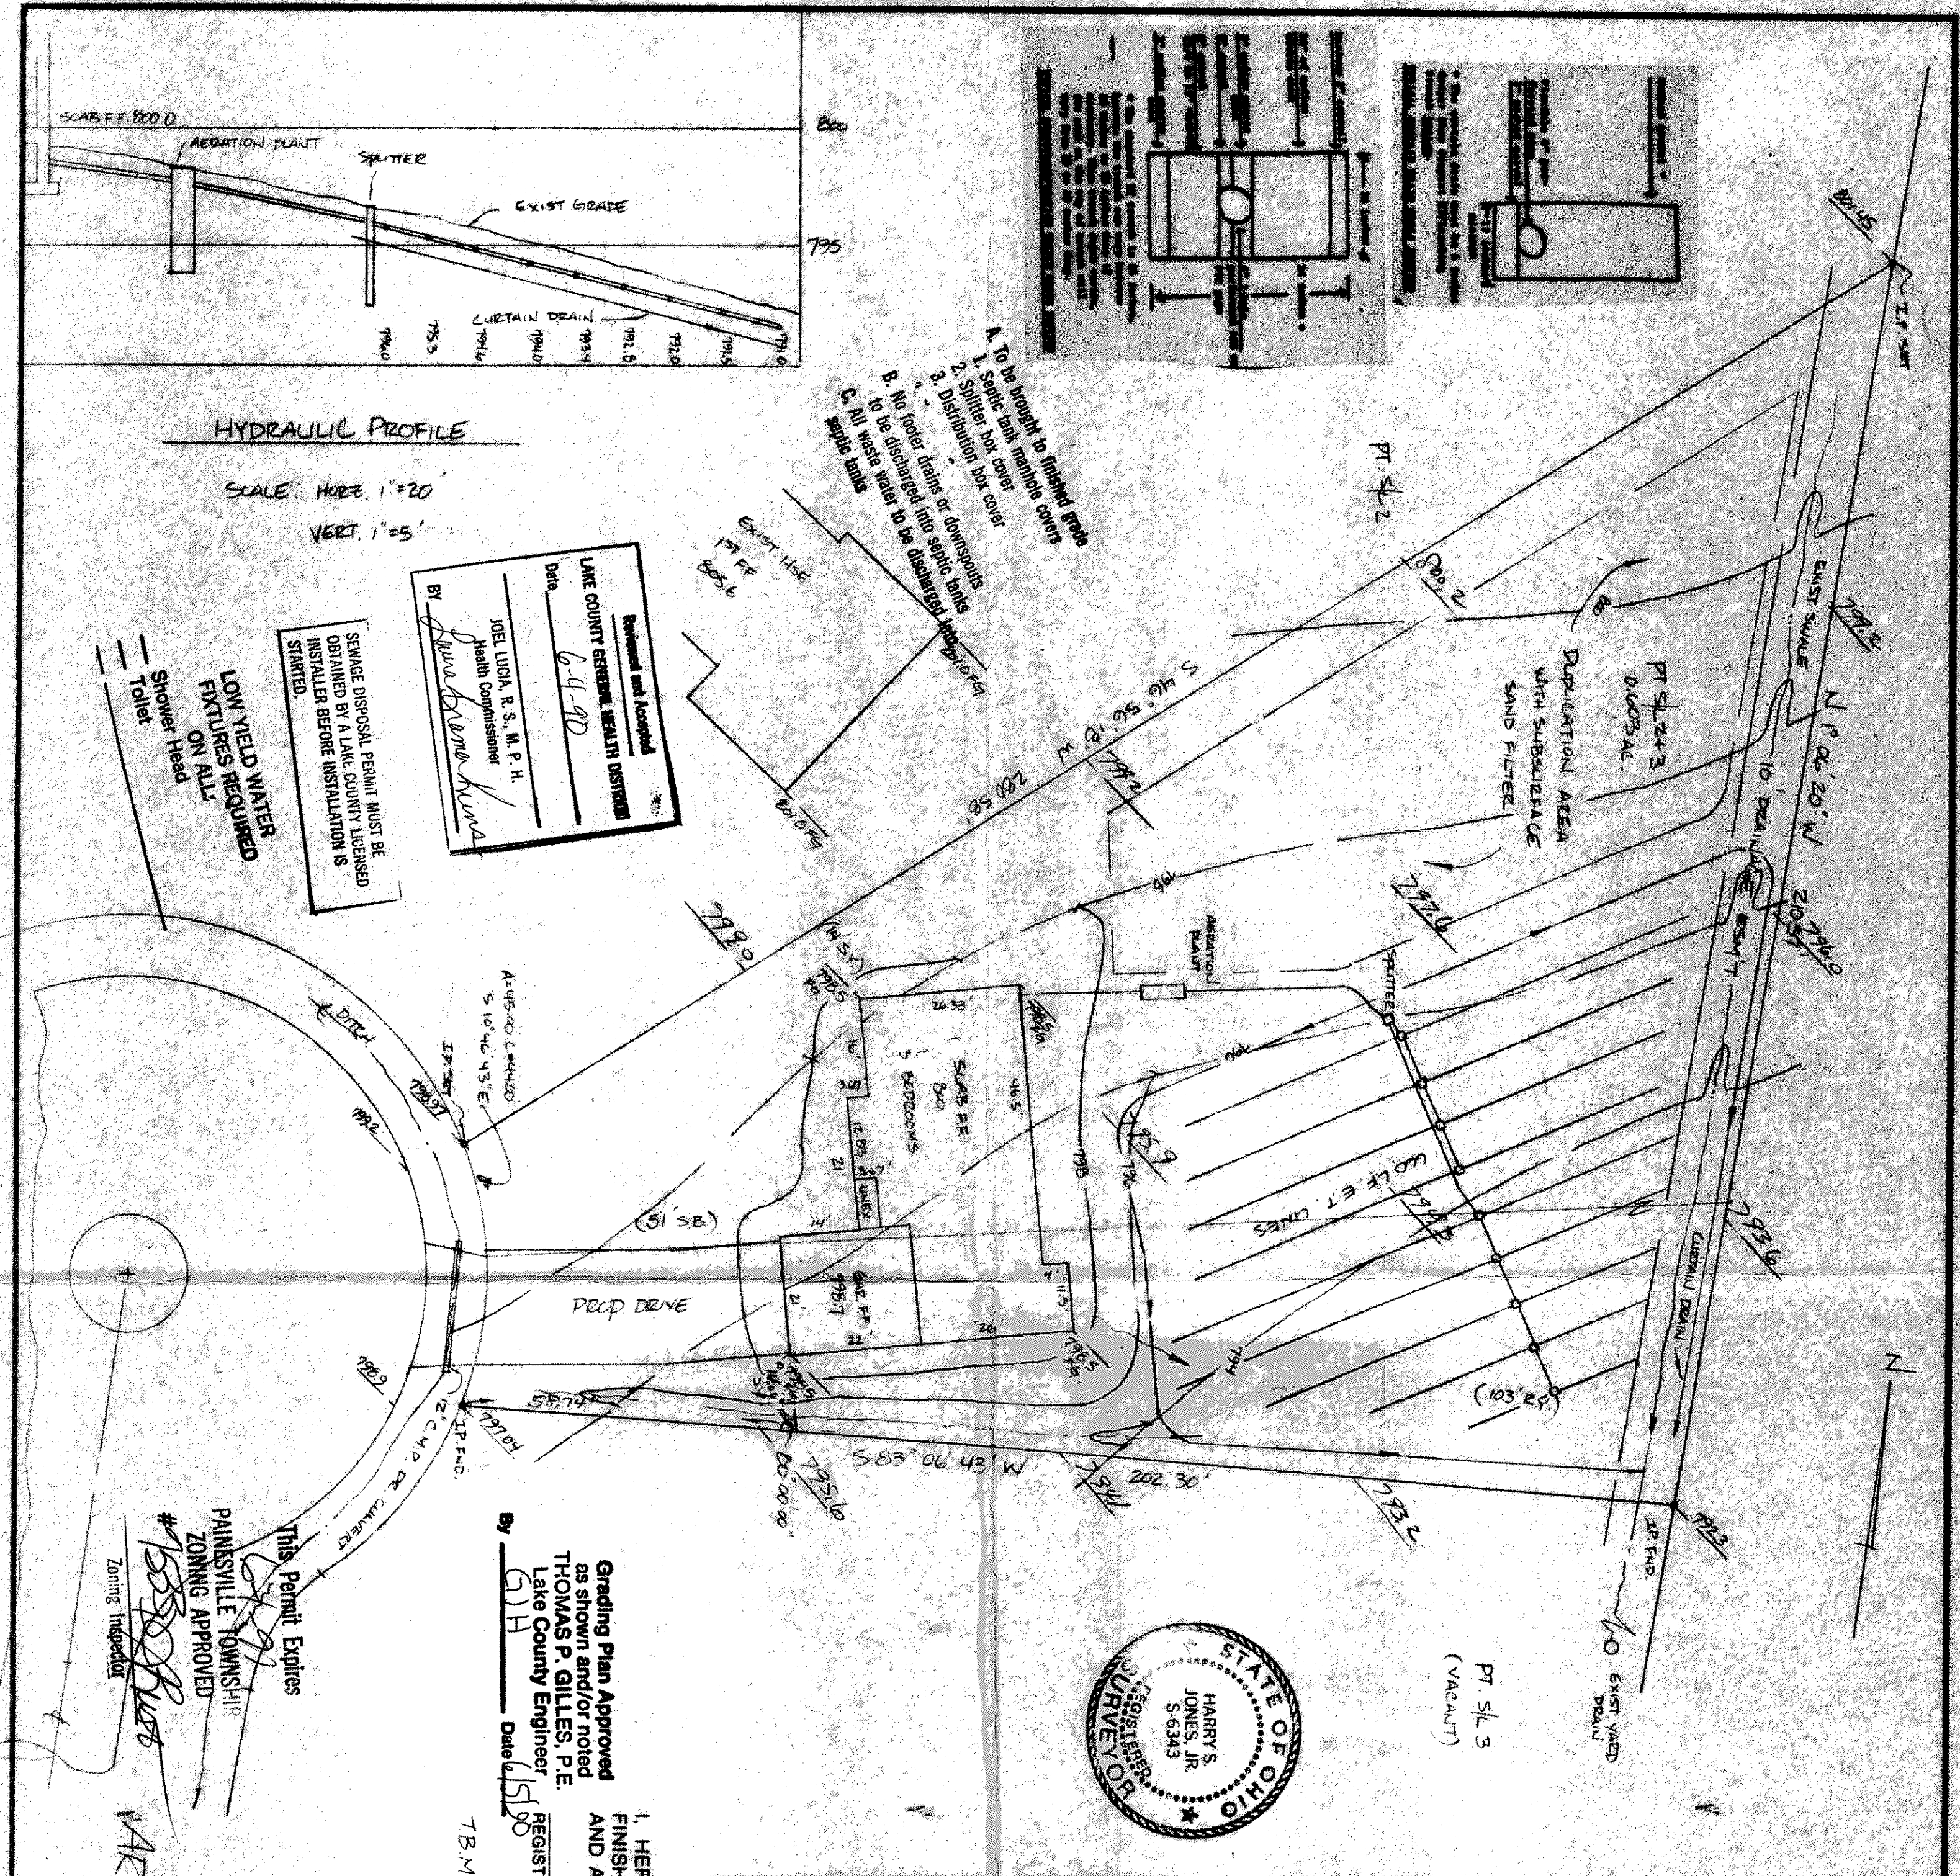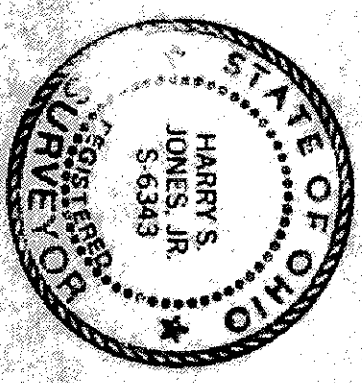

HYDRAULIC PROFILE
SCALE: HORIZ. 1"=20'
VERT. 1"=5'

Reviewed and Accepted
LAKE COUNTY GENERAL HEALTH DISTRICT
Date 6-4-90
JOEL LUCIA, R.S., M.P.H.
Health Commissioner
BY: [Signature]

SEWAGE DISPOSAL PERMIT MUST BE
OBTAINED BY A LAKE COUNTY LICENSED
INSTALLER BEFORE INSTALLATION IS
STARTED.

LOW YIELD WATER
FIXTURES REQUIRED
ON ALL
Shower Head
Toilet